


RECEIVED
STATE OF COLORADO
PUBLIC UTILITIES
2011 OCT 28 AM 9:20

EXHIBIT
AS

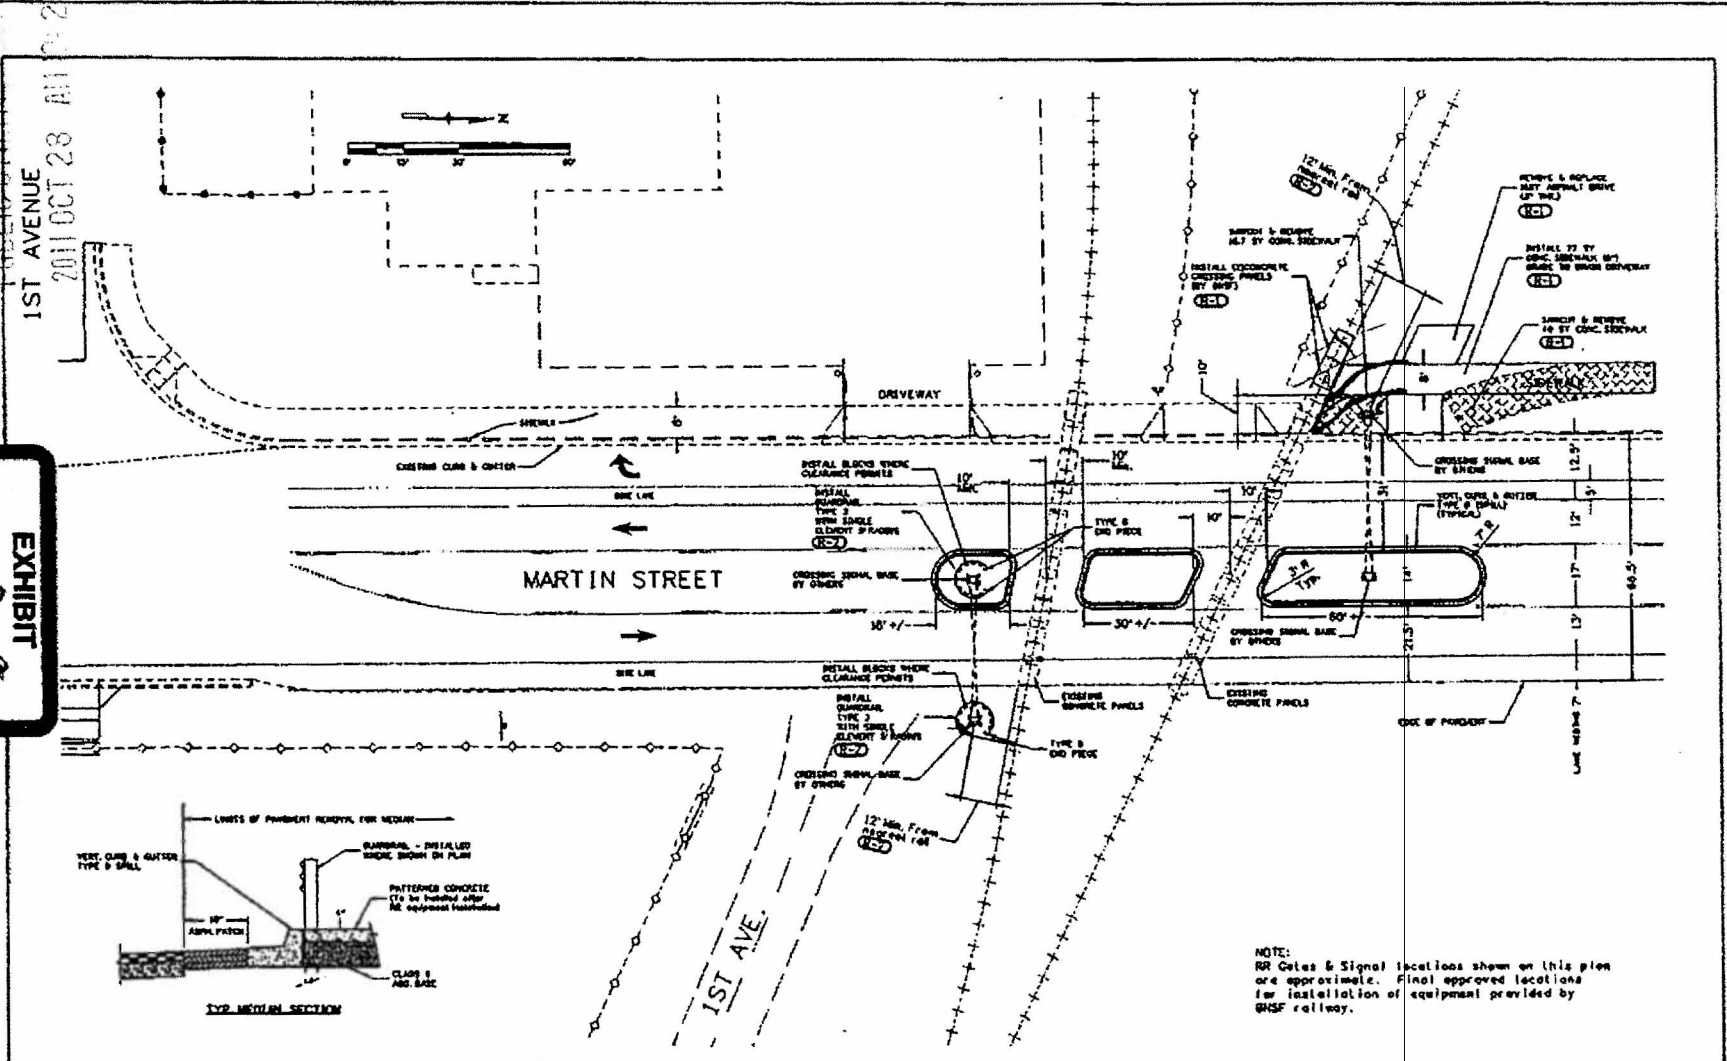



NOTE:
RR Gates & Signal locations shown on this plan are approximate. Final approved locations for installation of equipment provided by BNSF railway.


Print Date: 08/22/2011	Sheet Revisions			CITY of LONGMONT 385 Kimbark Street Longmont, CO 80501 Phone: 303-651-8304 FAX: 303-651-8352	As Constructed	MARTIN STREET RAILROAD SIGNAL MEDIANS		Project No./Year
File Name: Railroad Crossing-Sheet Logn	Date:	Comments:	Inst.:		No Revisions:	Designer: CA	Structure: Members	2011
Scale: 1"=30'	6/14/11	Added SW & RR panels	AM	Revised:	Detailer: AM			
Engineering Services: TS	9/21/11	Lanes & Median Dim.	AM	Valid:	Sheet Subst:	Detail Sheet:	Sheet Number: 1	



Exh. No. 3
 Appl. No. 10A-107R
 Witness _____
 Date 10-25-11 *File*

EXHIBIT 3A

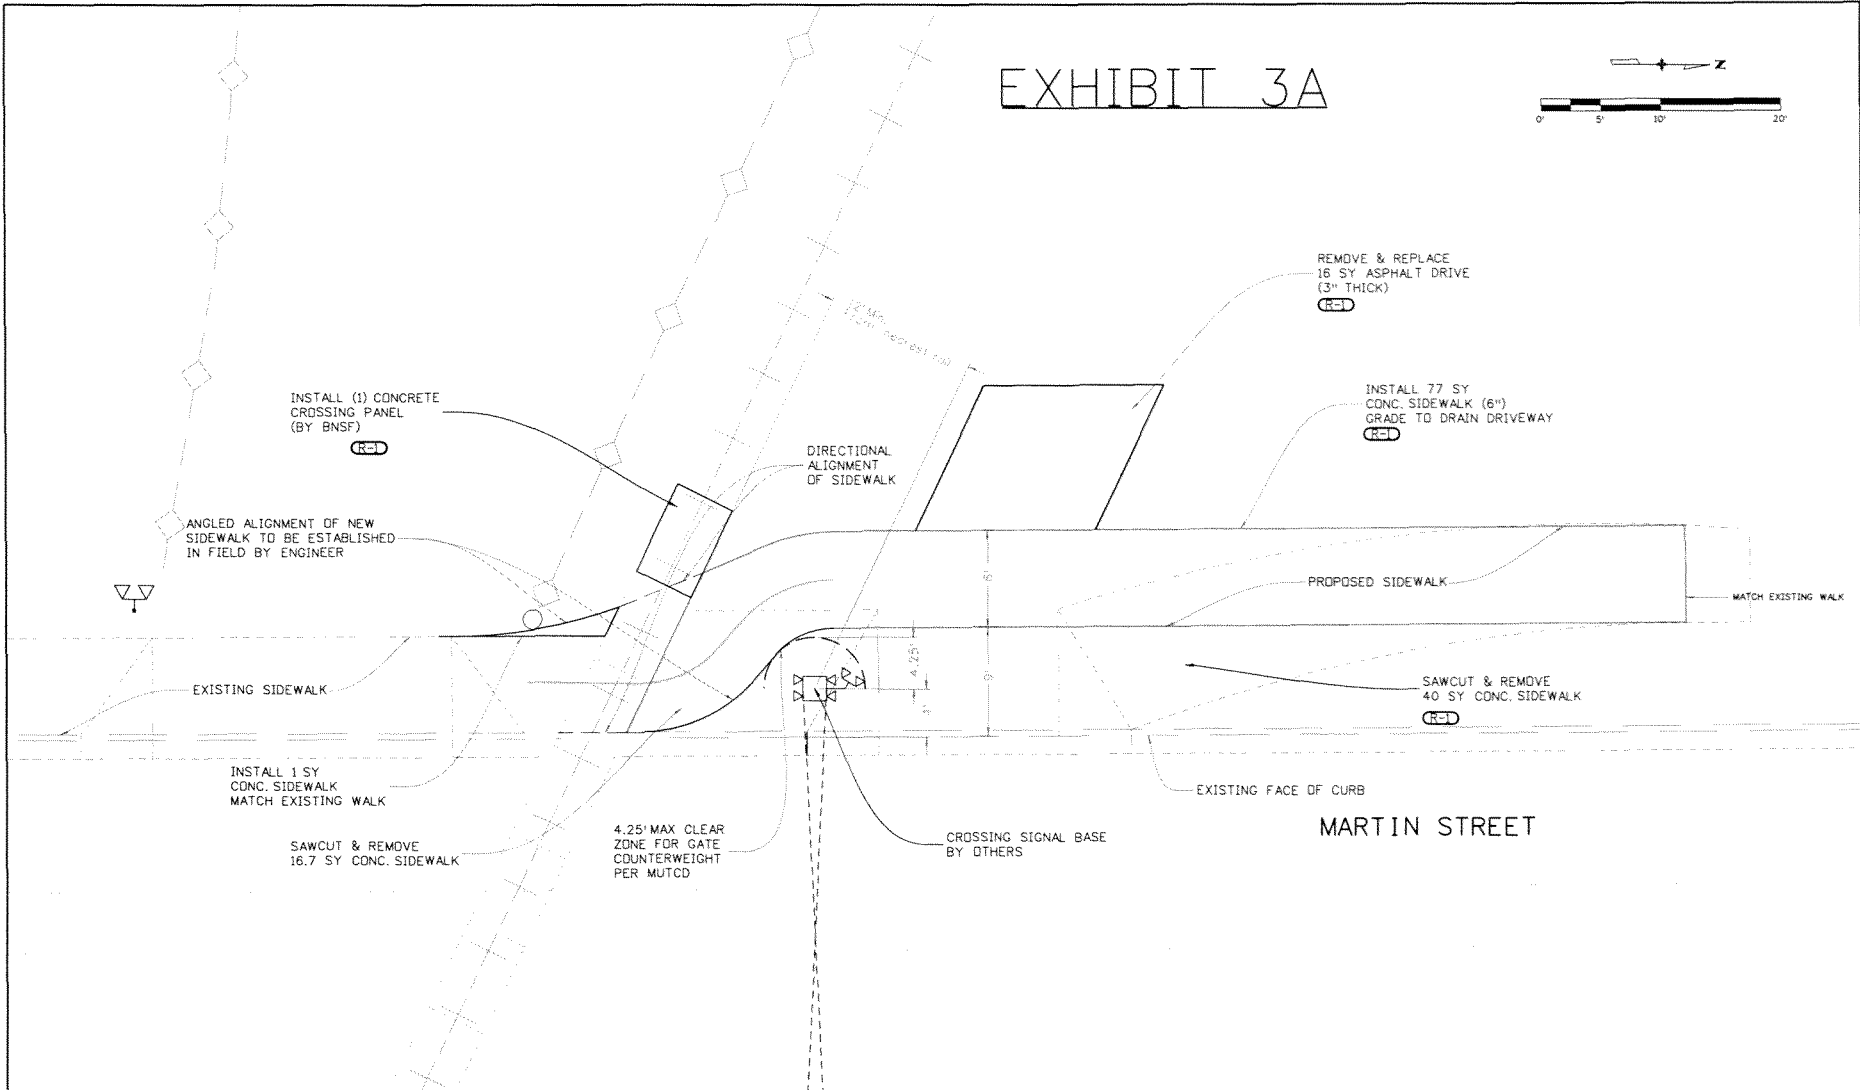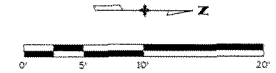

Print Date: 11/02/2011	Sheet Revisions			 CITY of LONGMONT 385 Kimbark Street Longmont, CO 80501 Phone: 303-651-8504 FAX: 303-651-8352 PUBLIC WORKS & NATURAL RESOURCES DEPT.	As Constructed	MARTIN STREET		Project No./Year
File Name: Railroad Crossing-Sheet 2-sidewalk revisions(2).dgn	Date:	Comments	Init.		No Revisions:	PROPOSED SIDEWALK ALIGNMENT		563003
Horiz. Scale: 1:10 Vert. Scale: As Noted				Revised:	Designer: CA	Structure Numbers:	2011	
Unit Information Unit Leader Initials				Void:	Detailer: AM	Sheet Subset: /	Sheet Number	
						Subset Sheets:	2	

m:\projects\2011\563003\design\working\Railroad Crossing-Sheet 2-sidewalk revisions(2).dgn