Colorado PUC E-Filings System

RECEIVED
STATE OF COLORADO
PUBLIC UTILITIES
2011 OCT 28 AM

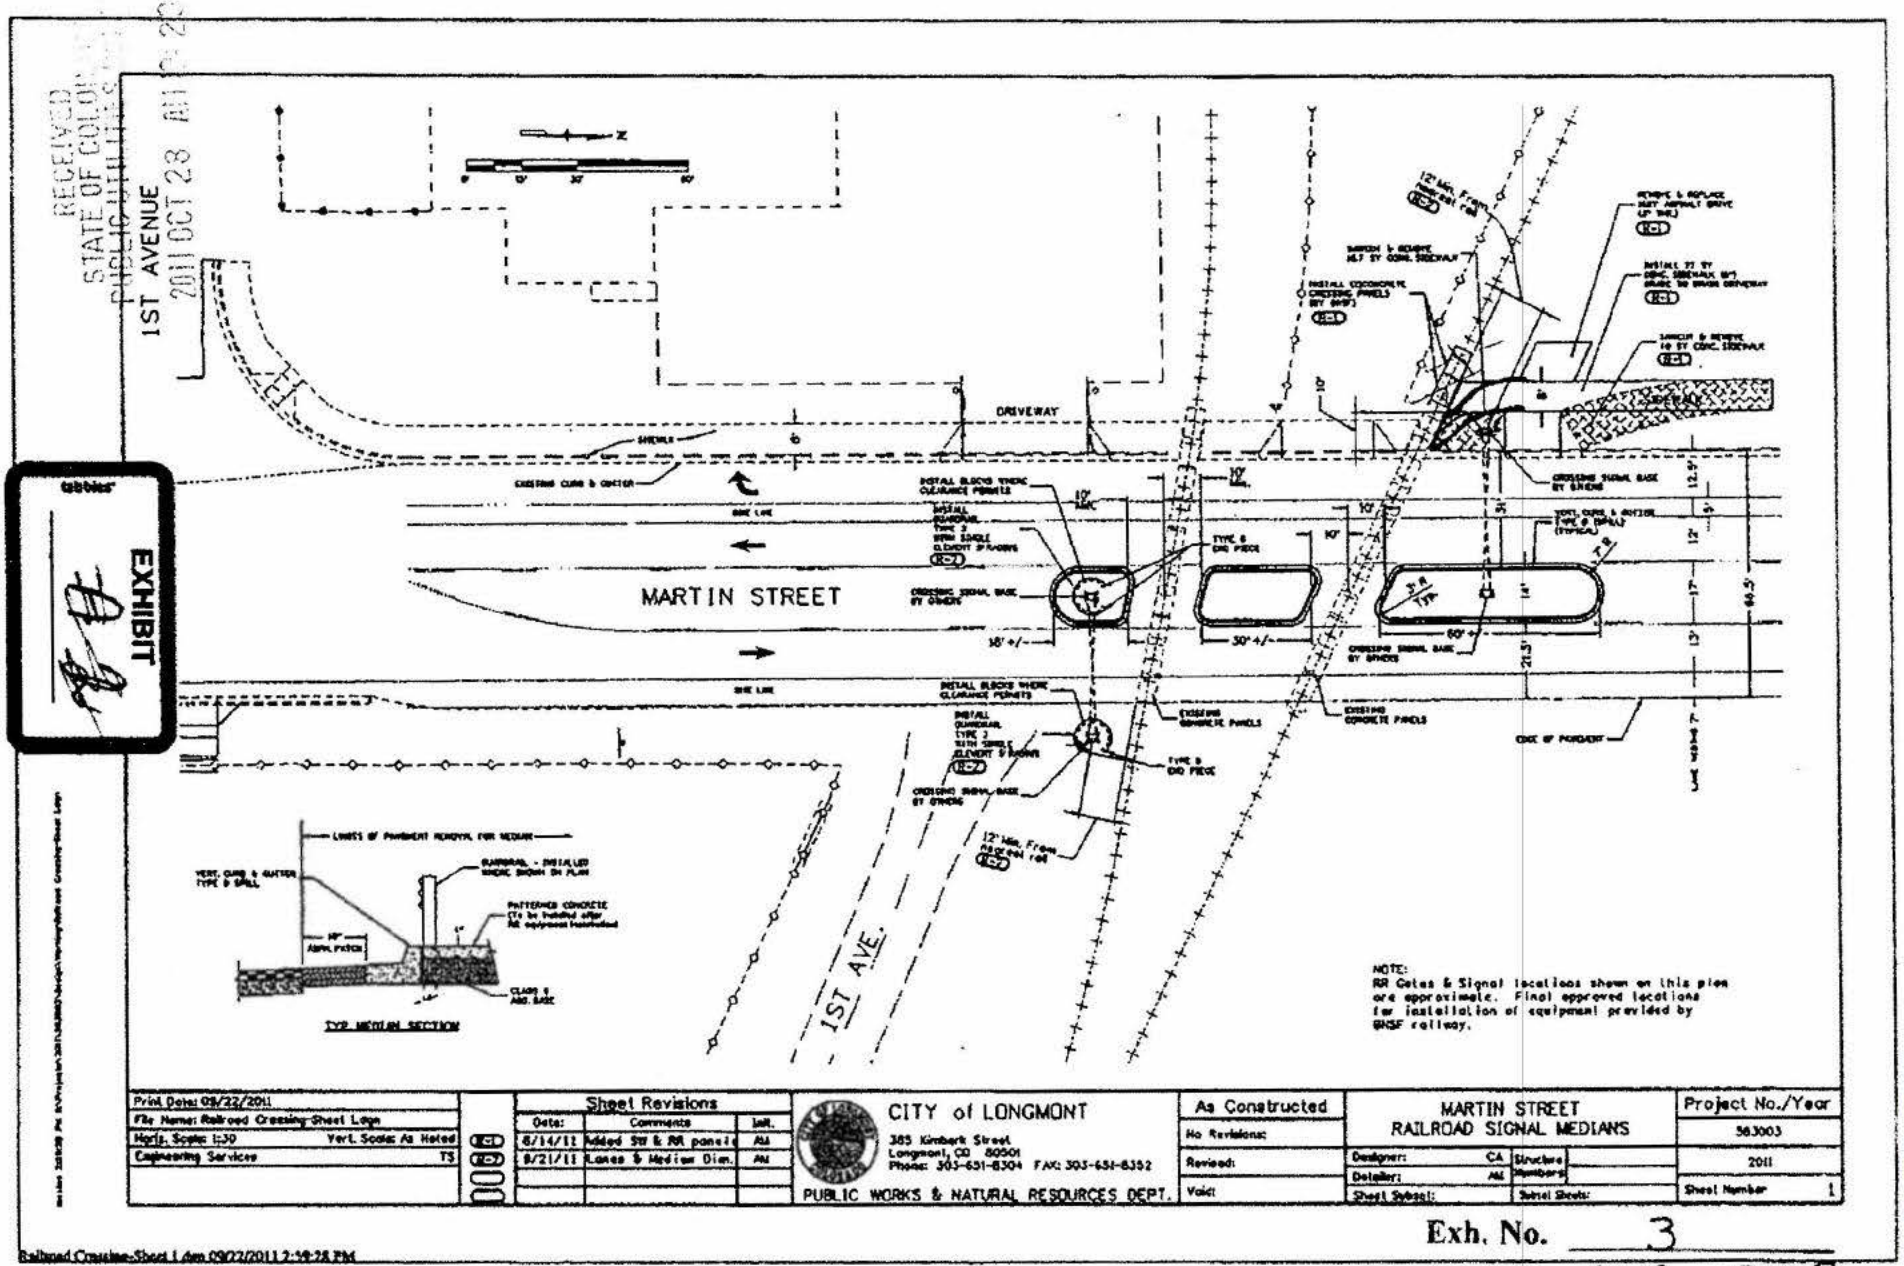

EXHIBIT

Exh. No. 3
Appl. No. 10A-107R
Witness
Date 10-25-11

Appendix A
Decision No. R11-1202
Docket Nos. 10A-107R & 11A-404R
Page 1 of 2

EXHIBIT 3A

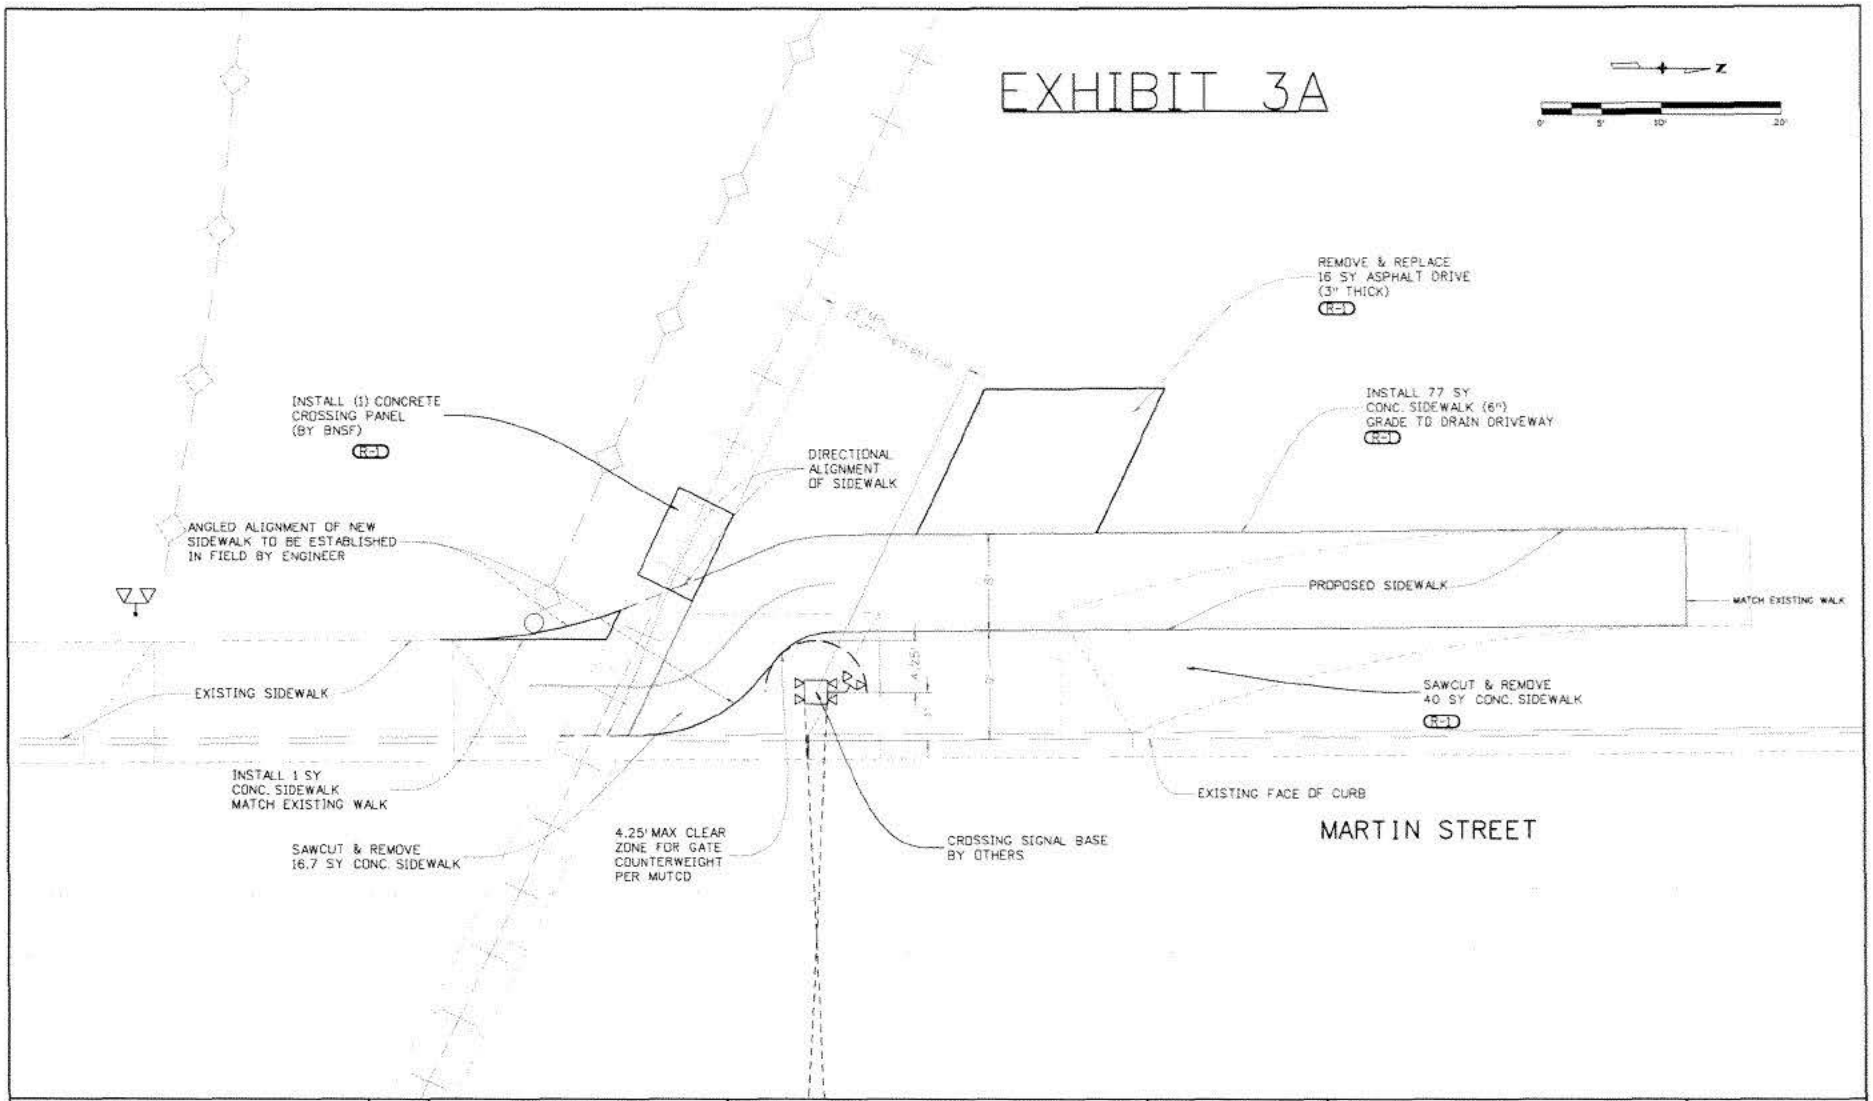

Print Date: 11/02/2011		Sheet Revisions			CITY of LONGMONT	As Constructed	MARTIN STREET PROPOSED SIDEWALK ALIGNMENT	Project No./Year
File Name: Railroad Crossing-Sheet 2-sidewalk revisions(2).dgn		Date:	Comments	Init.	385 Kimbark Street Longmont, CO 80501 Phone: 303-651-8304 FAX: 303-651-8352	No Revisions:		563003
Horiz. Scale: 1:10 Vert. Scale: As Noted	RCA					Revised:	Designer: CA Structure Numbers	2011
Unit Information Unit Leader Initials					PUBLIC WORKS & NATURAL RESOURCES DEPT.	Void:	Detailer: AM	Sheet Number 2
							Sheet Subset: Subset Sheets:	

meslak 2:45:39 PM I:\Projects\2011\563003\Design\Working\Railroad Crossing-Sheet 2-sidewalk revisions(2).dgn

Appendix A
Decision No. R11-1202
Docket Nos. 10A-107R & 11A-404R
Page 2 of 2