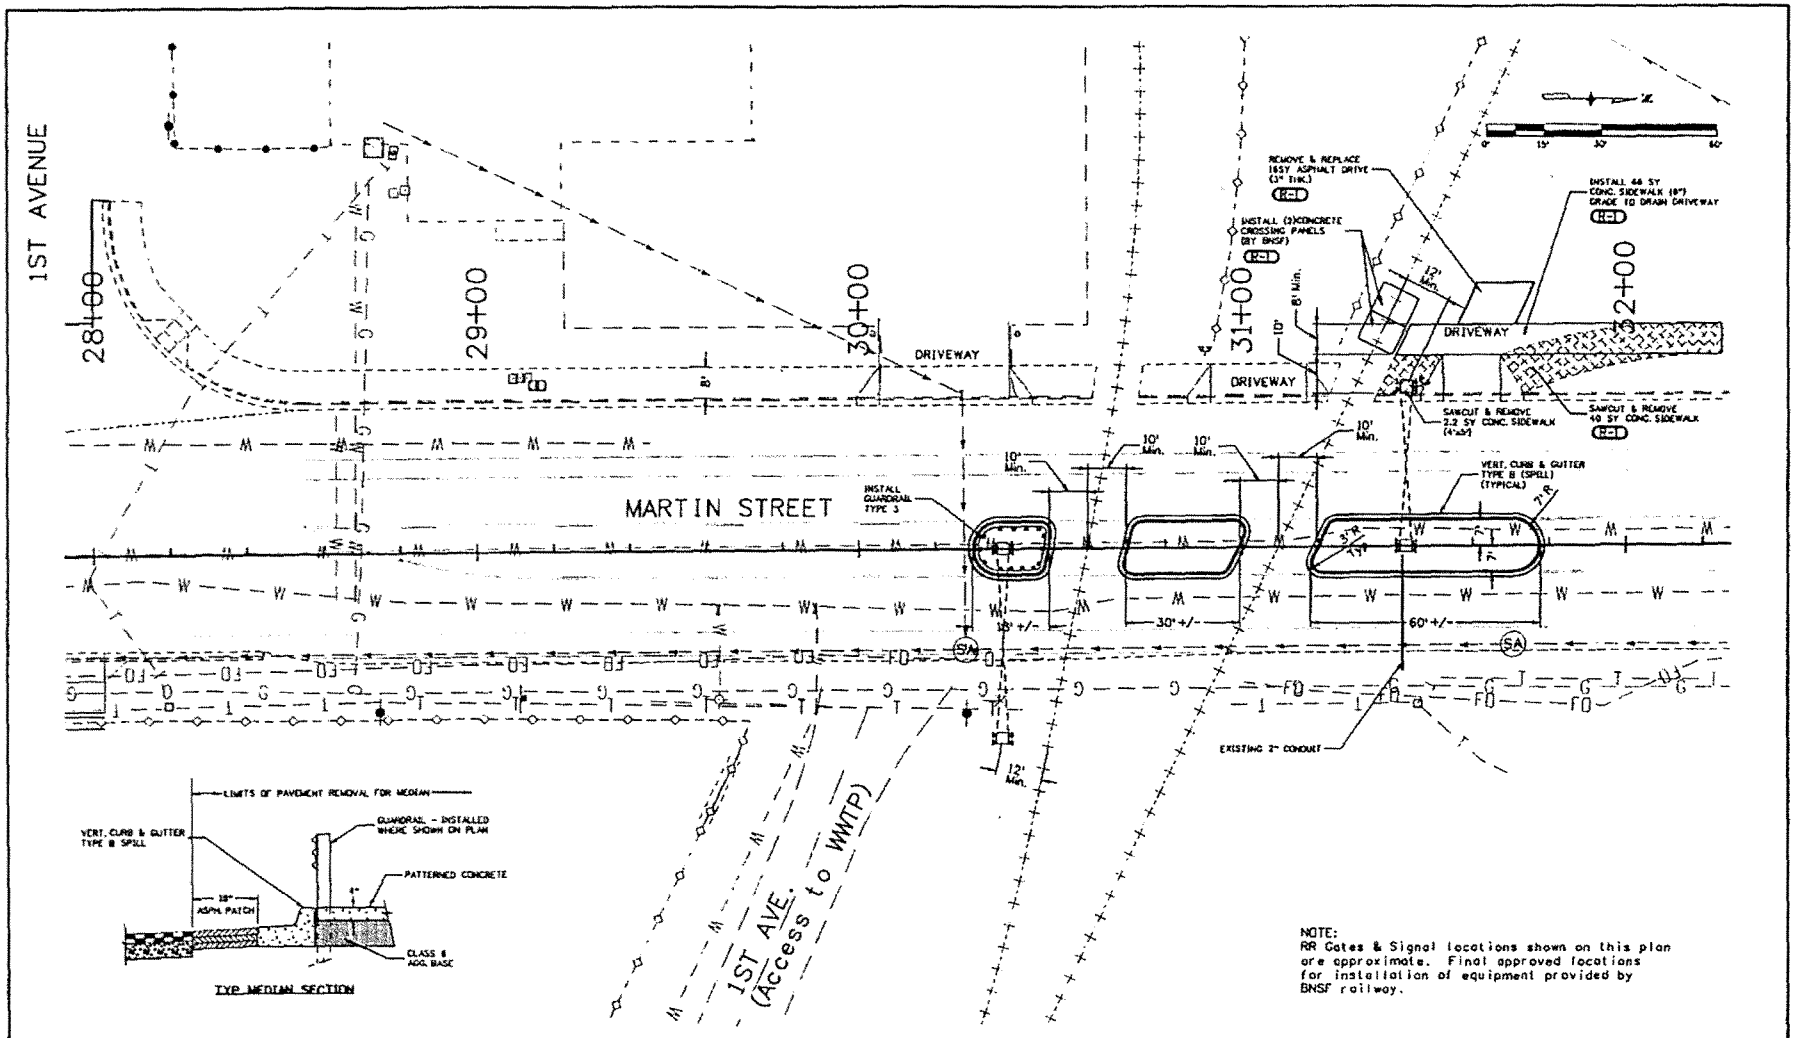

Print Date: 6/15/2011		Sheet Revisions			CITY of LONGMONT	As Constructed	MARTIN STREET RAILROAD SIGNAL MEDIANS	Project No./Year
File Name: Railroad Crossing-Sheet 1.dgn		Date:	Comments	Init.	385 Kimbark Street	No Revisions:		563003
Horiz. Scale: 1:30 Vert. Scale: As Noted	R-1	6/14/11	Added SW & RR panels	AM	Longmont, CO 80501	Revised:	Designer: CA / Structure Numbers:	2011
Engineering Services TS					Phone: 303-651-8304 FAX: 303-651-8352	Void:	Detailer: AM	Sheet Number 1
					PUBLIC WORKS & NATURAL RESOURCES DEPT.		Sheet Subset: / Subset Sheets:	

Exhibit 2

Exh. No. 6
Appl. No. 10A-107R
9/19/11

Colorado PUC E-Filings System